



LAURELDALE BUSINESS CENTER

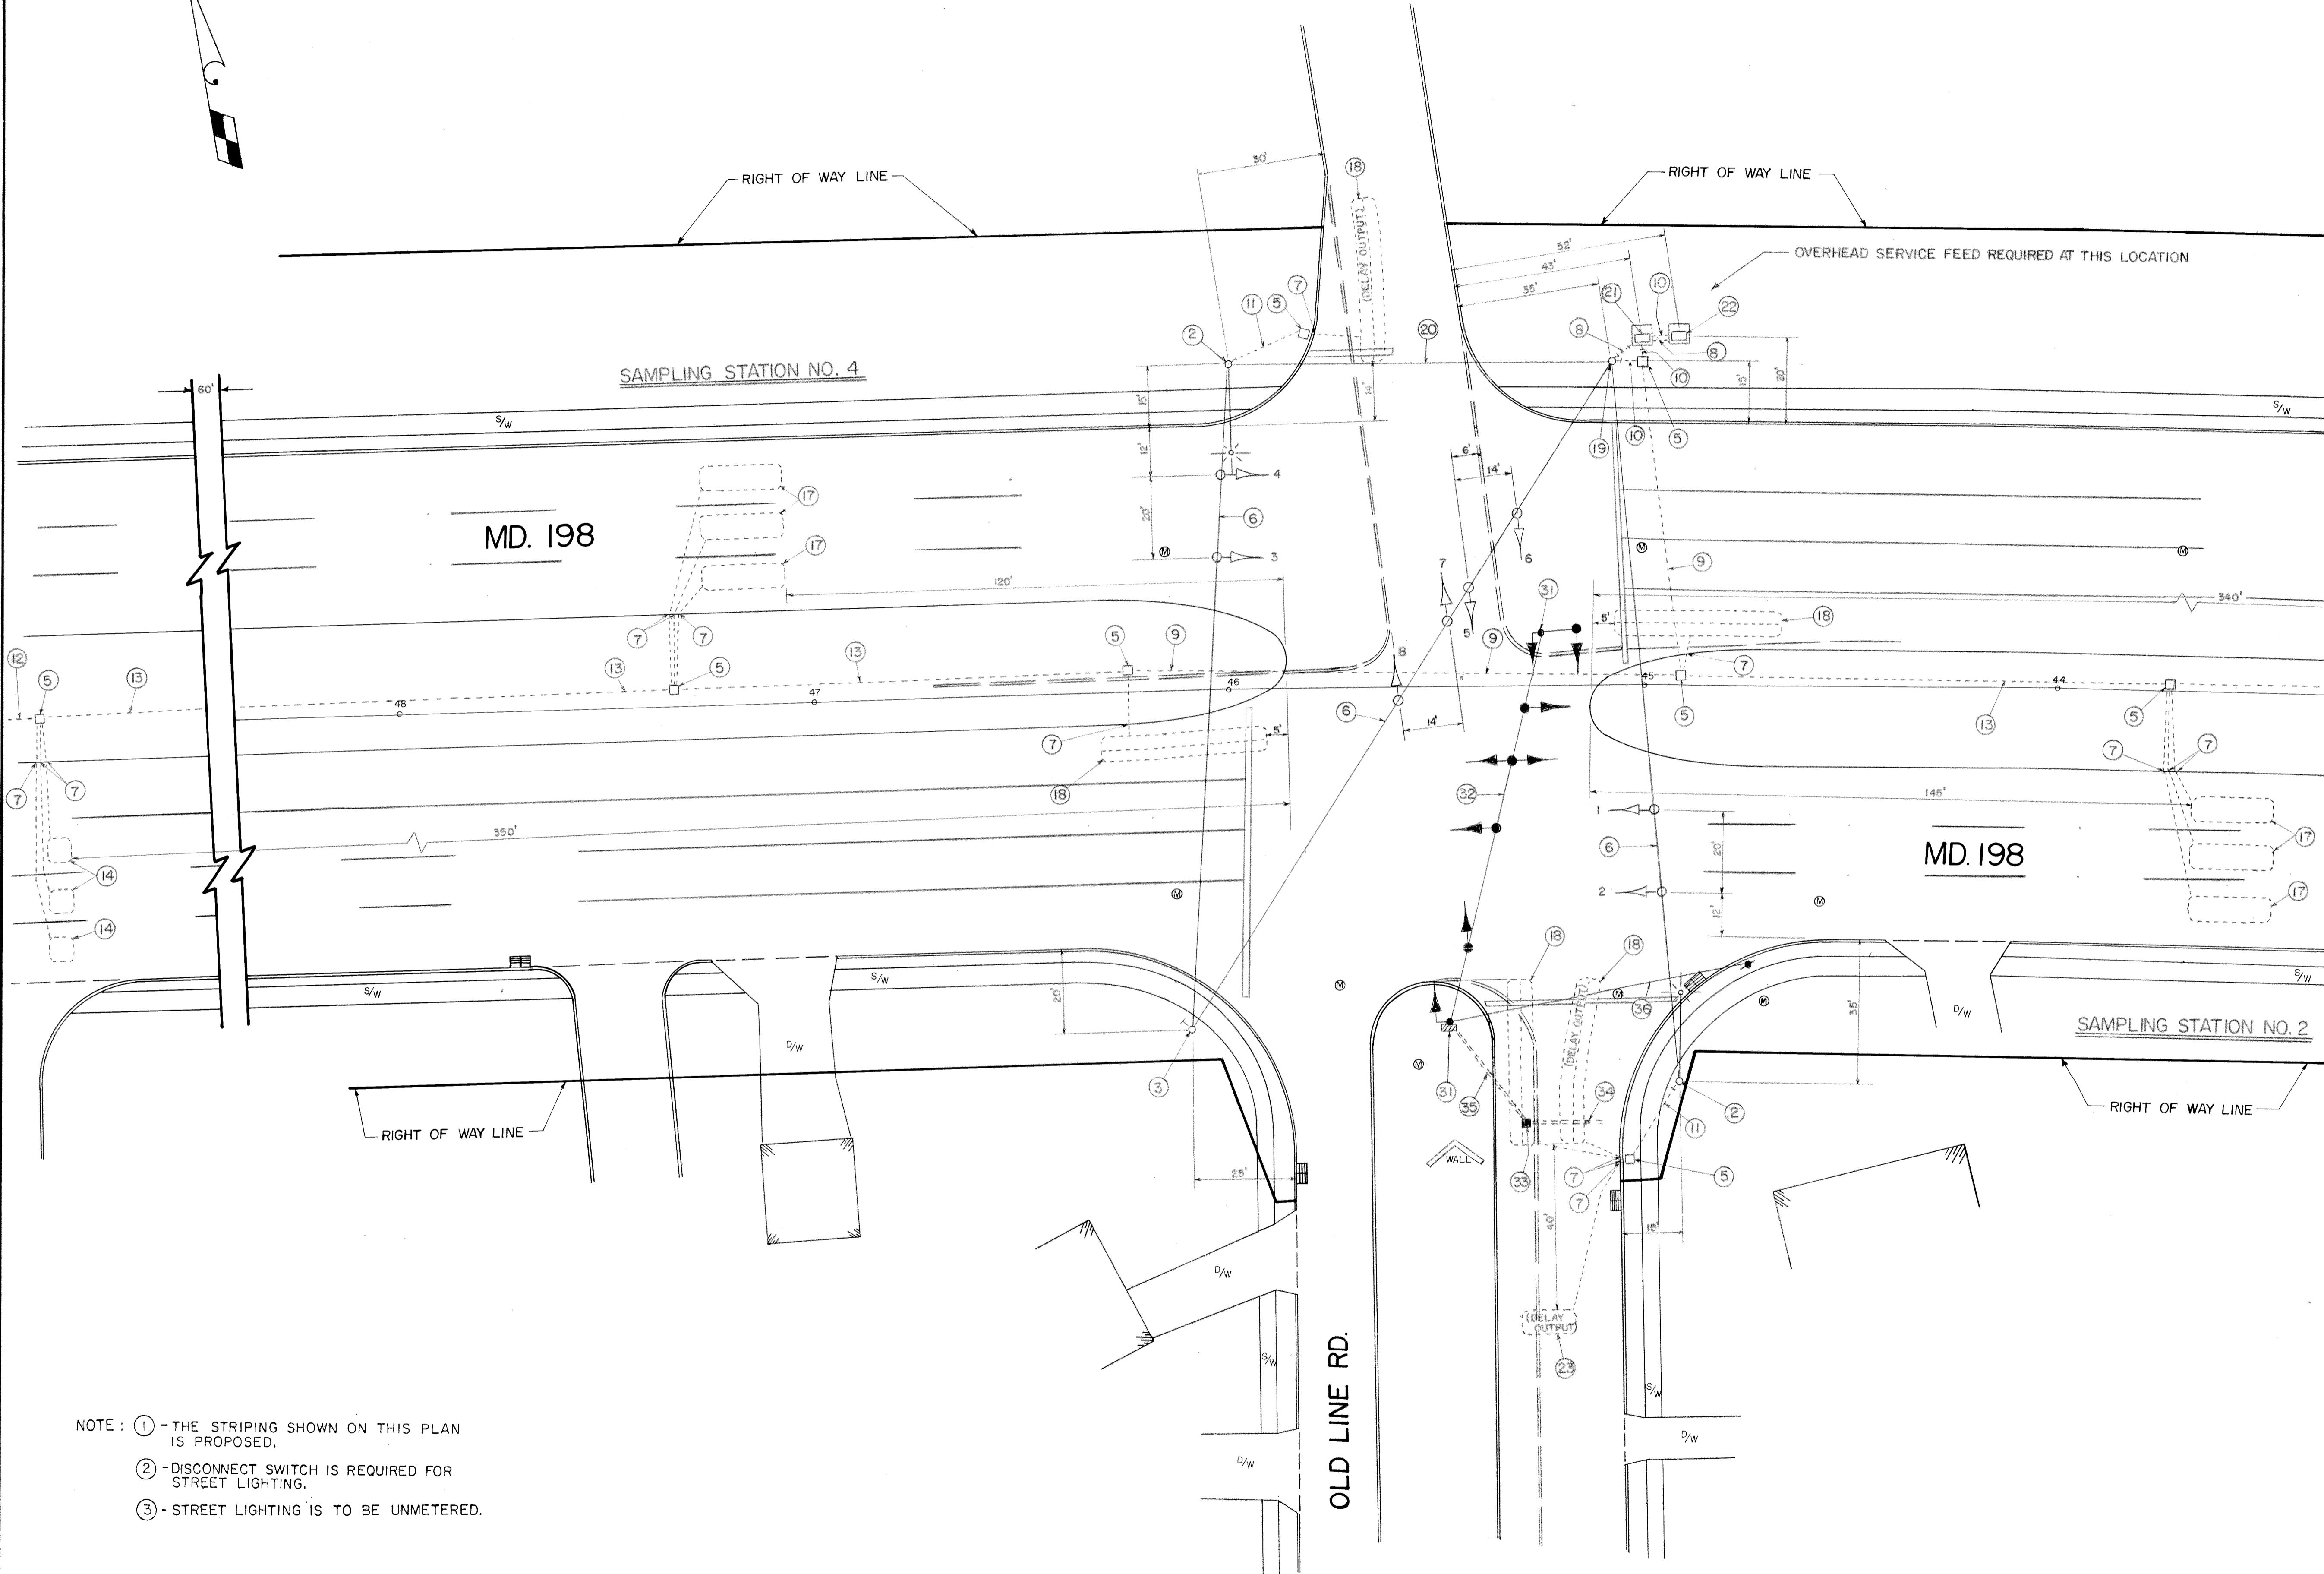

12" SIGNALS
1-8
R
Y
G

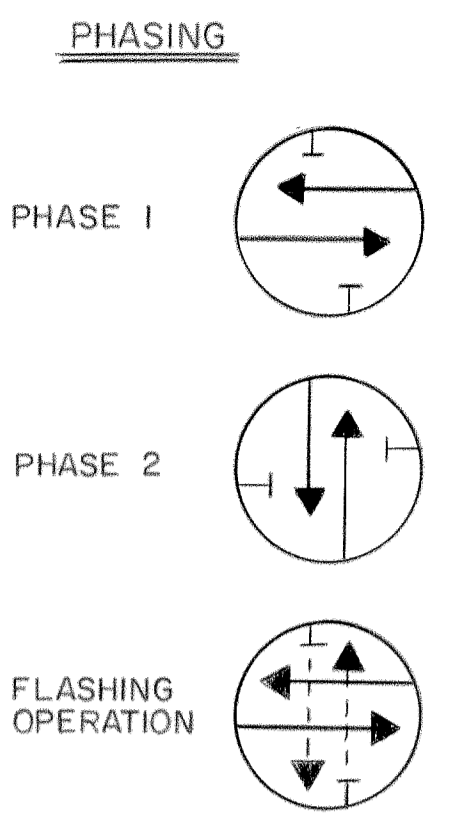

- NOTE: ① - THE STRIPING SHOWN ON THIS PLAN IS PROPOSED.
- ② - DISCONNECT SWITCH IS REQUIRED FOR STREET LIGHTING.
- ③ - STREET LIGHTING IS TO BE UNMETERED.

APPROVAL: <i>Shannon E. Eshard</i> 1/25/83 CHIEF SIGNAL DESIGN SECTION		<table border="1"><tr><td>C</td><td>DEC 17, 1982</td></tr><tr><td colspan="2">REDRAWN. ADD PROPOSED GEOMETRICS TO DRAWING.</td></tr><tr><td>HJK</td><td></td></tr><tr><td>B</td><td>7-12-73</td></tr><tr><td colspan="2">ASBUILT A-AA-5419-72</td></tr><tr><td>FMD</td><td>DD</td></tr><tr><td>A</td><td>5-23-73</td></tr><tr><td colspan="2">RELOCATED POLE ON NORTH SIDE AND INSTALLED LOOP IN NORTH APPROACH.</td></tr><tr><td>DD</td><td></td></tr><tr><td colspan="2">REVISIONS</td></tr></table>	C	DEC 17, 1982	REDRAWN. ADD PROPOSED GEOMETRICS TO DRAWING.		HJK		B	7-12-73	ASBUILT A-AA-5419-72		FMD	DD	A	5-23-73	RELOCATED POLE ON NORTH SIDE AND INSTALLED LOOP IN NORTH APPROACH.		DD		REVISIONS	
C	DEC 17, 1982																					
REDRAWN. ADD PROPOSED GEOMETRICS TO DRAWING.																						
HJK																						
B	7-12-73																					
ASBUILT A-AA-5419-72																						
FMD	DD																					
A	5-23-73																					
RELOCATED POLE ON NORTH SIDE AND INSTALLED LOOP IN NORTH APPROACH.																						
DD																						
REVISIONS																						
APPROVAL: REGIONAL TRAFFIC ENGINEER																						
APPROVAL: <i>Howard J. Heltgen</i> 1/21/83 CHIEF BUREAU OF TRAFFIC ENGINEERING																						
APPROVAL: <i>John Smith</i> 1/21/83 ASST. CHIEF ENGINEER TRAFFIC																						
STATE OF MARYLAND DEPARTMENT OF TRANSPORTATION STATE HIGHWAY ADMINISTRATION TRAFFIC DIVISION - BUREAU OF TRAFFIC ENGINEERING MD. 198 and OLD LINE RD. SCALE 1" = 20' DATE 5 18 73 CONTRACT NO. AA 487 501 571 P 762-503-371 DRAWN BY: F.D., D.D. H KILIAN COUNTY: ANNE ARUNDEL DESIGNED BY: <i>Howard J. Heltgen</i> SIGNAL NO.: 02101 CHECKED BY: _____ DRAWING NO. TS-916 C																						